


Übersicht Stadt Mülheim an der Ruhr



An aerial photograph of a residential neighborhood with several buildings, trees, and roads. Overlaid on the image are various colored arrows and text labels indicating traffic flow and specific areas of interest. A red arrow points from the top right towards the center-left, labeled "Reiterhofweg zu den Ruhrwiesen". A green arrow points from the bottom right towards the center-left, labeled "Fußgänger Radfahrer". A white arrow points from the top left towards the center-right, labeled "IV". Another white arrow points from the bottom left towards the center-right, also labeled "IV". A blue rectangle outlines a specific area, labeled "BA_1". The text "Parkverbot in diesem Bereich" is written in pink, with a white arrow pointing to a specific spot near the center. The label "Reiterhof" is written in red next to a large building on the left.

Baustelleneinrichtungsflächen

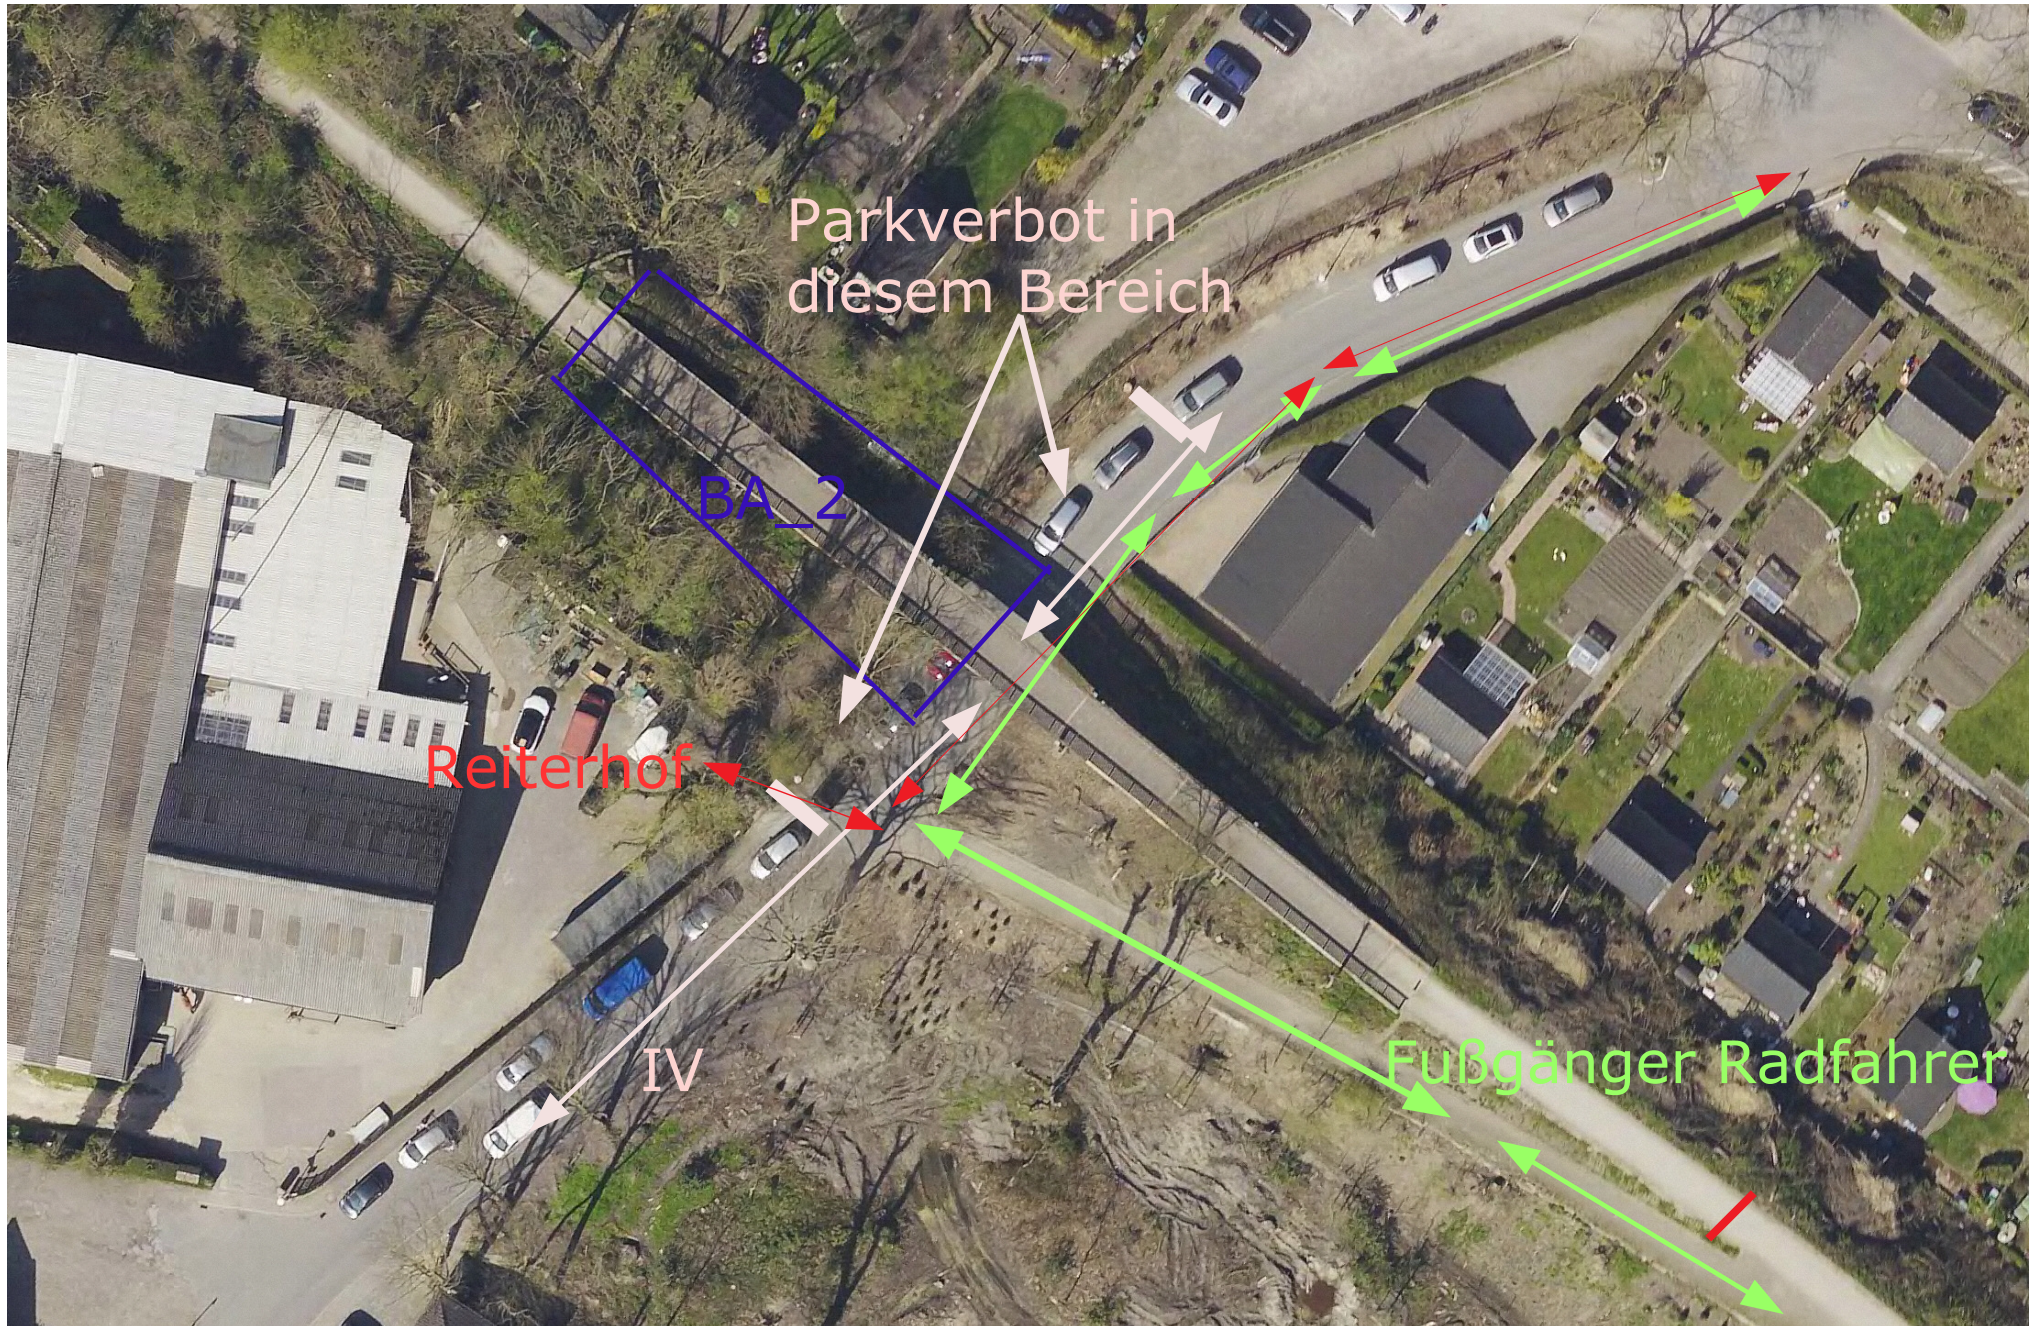


Baustellenzufahrt



Umleitung Fuß- und Radweg



Bestandsübersichtsplan

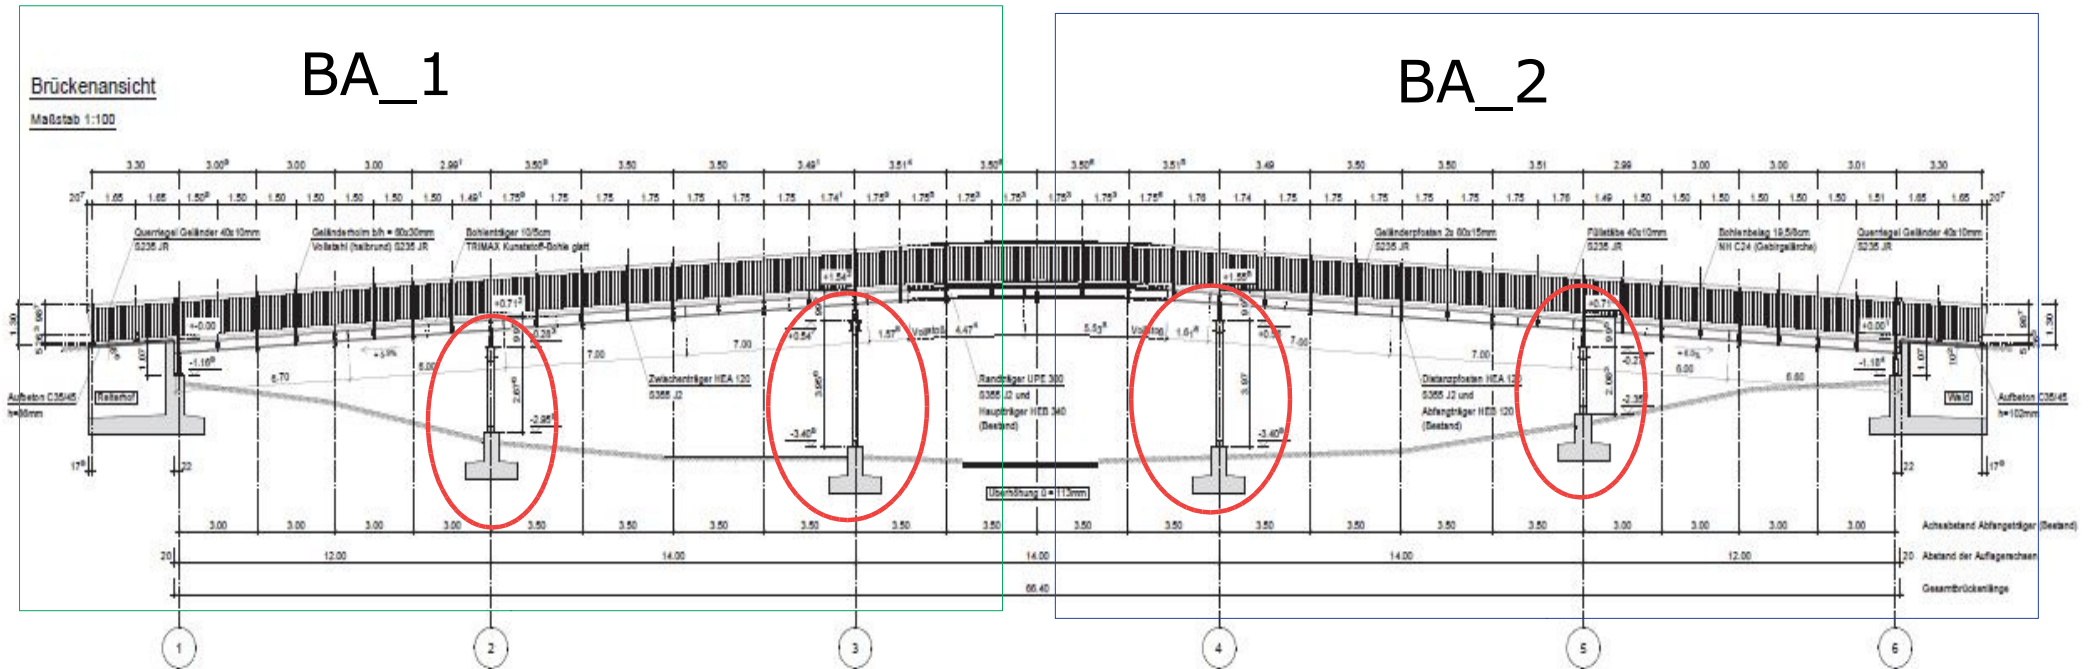

Bilddokumentation Bestand



Achse 2



Achse 3




Achse 5



Achse 4

Entwurfsskizze



Querschnitt Brücke Holunderstraße

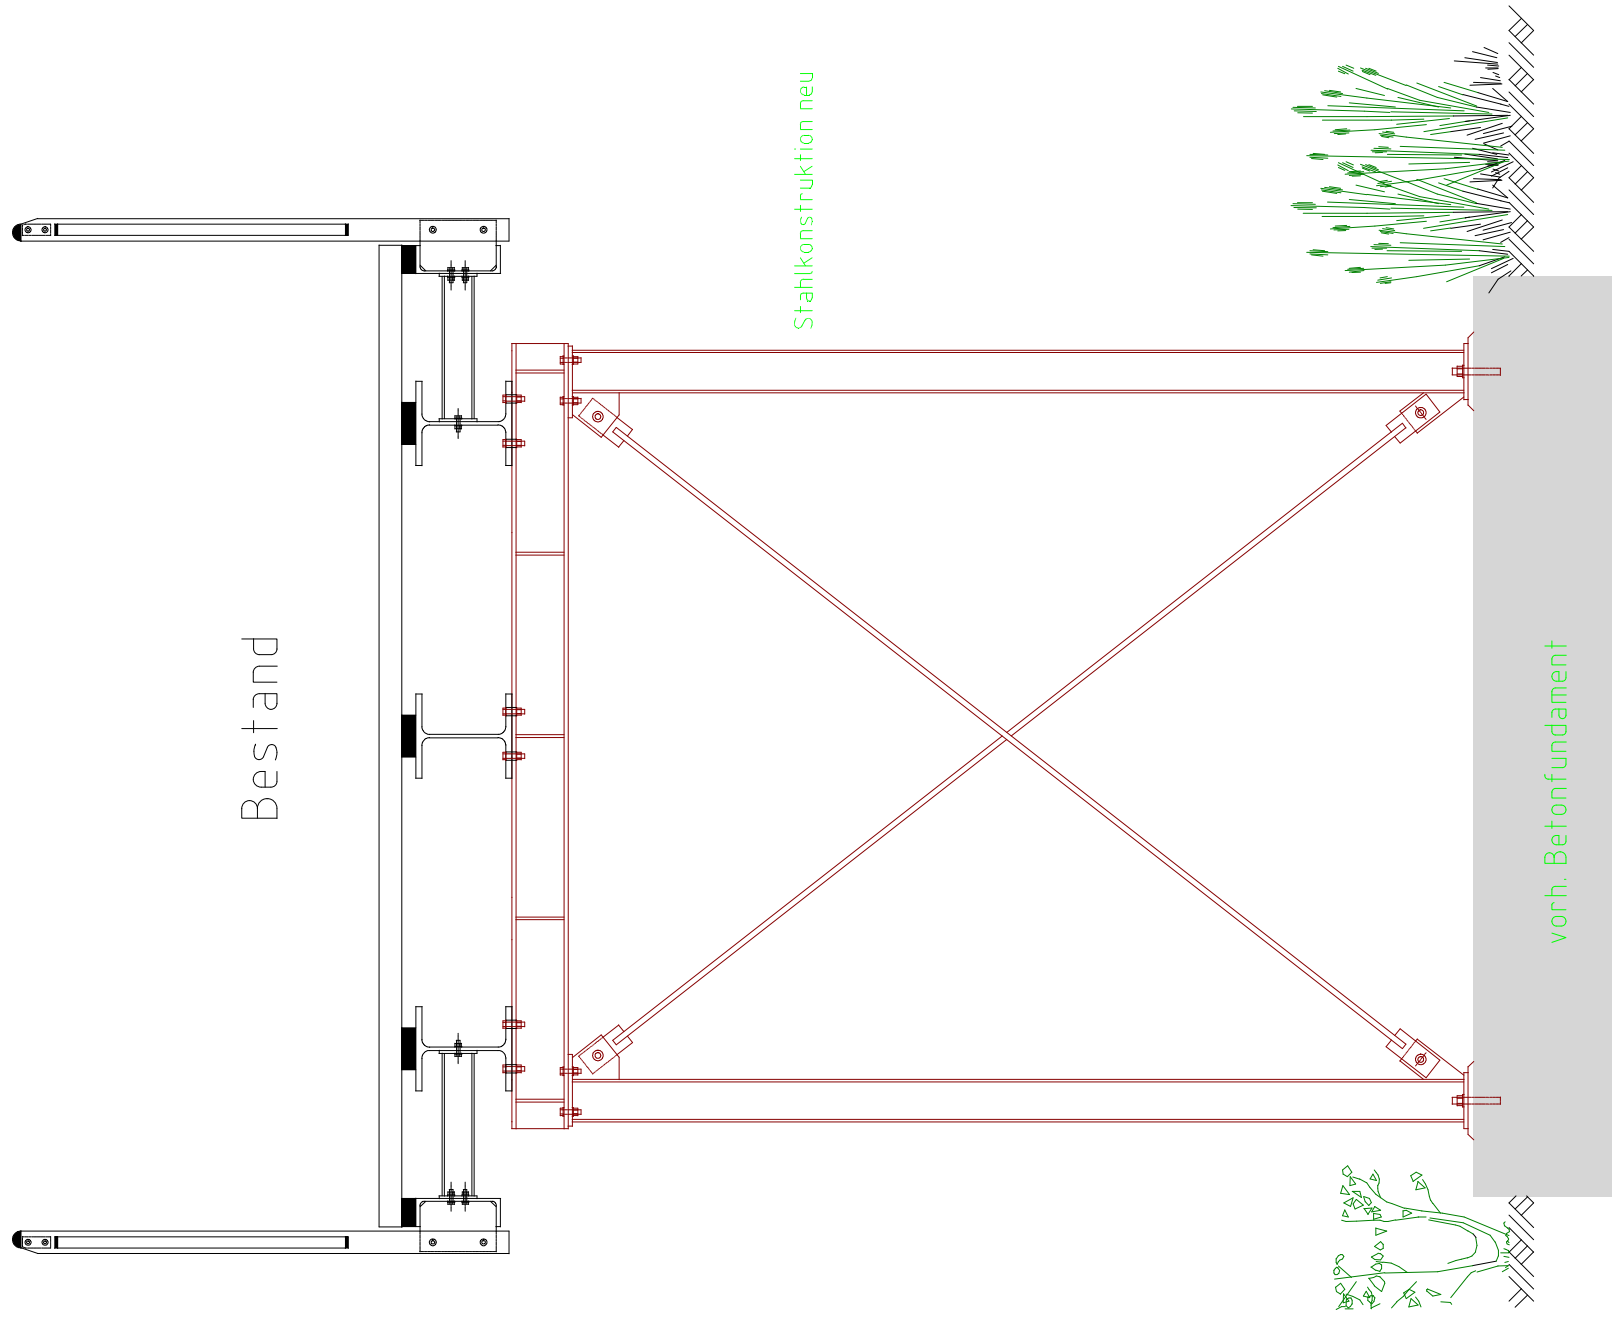

Stadt Mülheim an der Ruhr
Amt für Verkehrswesen und Tiefbau
Abtl. Brücken- und Ingenieurbau
gez. H. Miroshnicenko 12.03.2021

Bestandspläne Joche

Achse 2 und 5

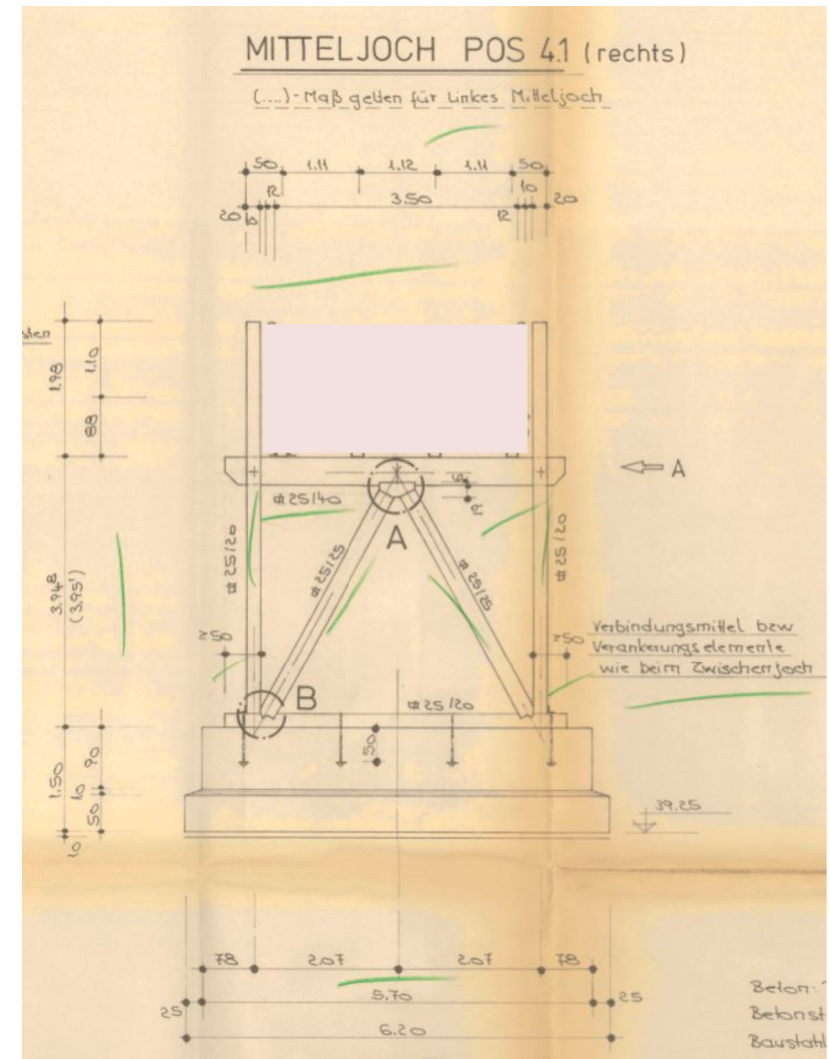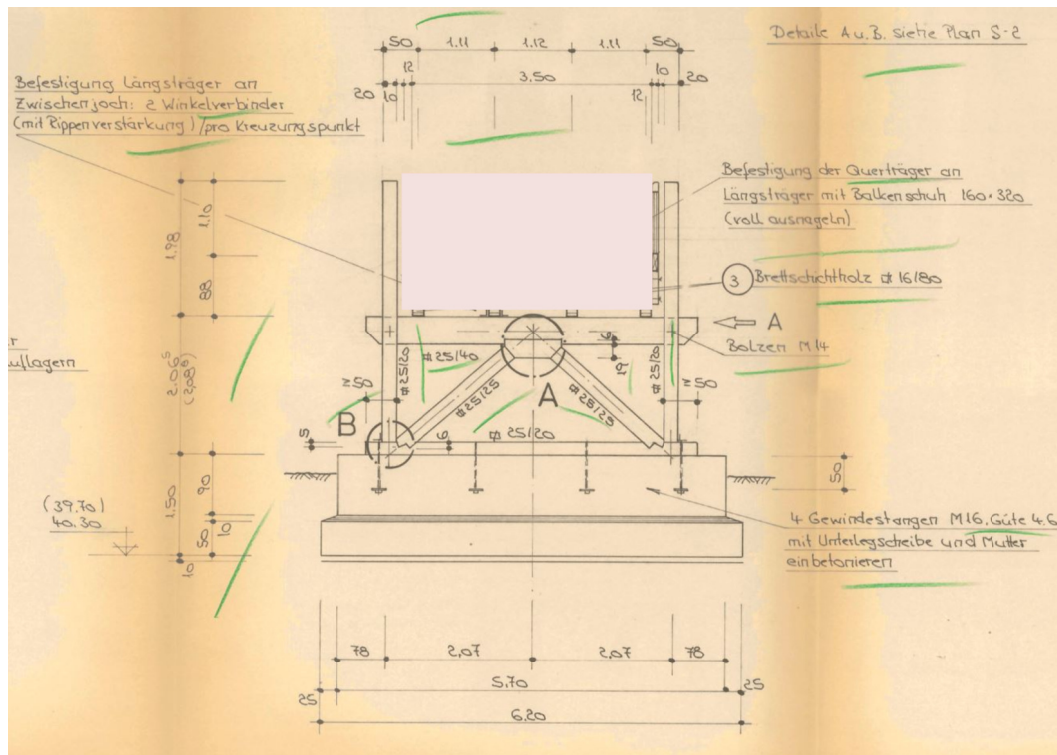

Achse 3 und 4